



Side Elevations

AS INSTALLED

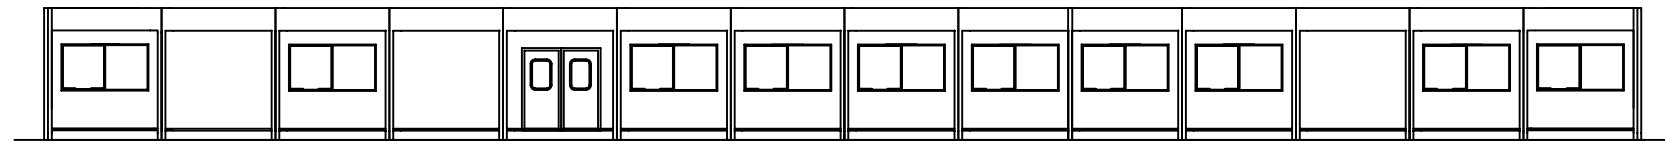


Rear Elevation

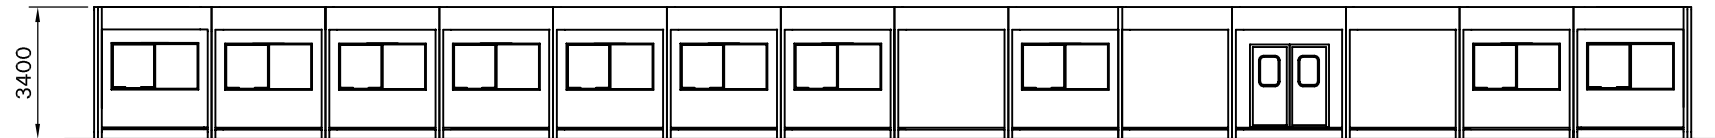

Front Elevation

EXTERNAL COLOUR SCHEME

Walls	- Silk Grey	nearest BS ref 10 A 05
Vertical wall trim	- Silk Grey	nearest BS ref 10 A 05
Bottom wall trims	- White	nearest BS ref 00 E 55
Long wall fascias (covering wall)	- Silk Grey	nearest BS ref 10 A 05
Long wall fascia (covering beam)	- White	nearest BS ref 00 E 55
Short wall composite fascia	- Slate Grey	nearest BS ref 18 B 25
Roof	- White	nearest BS ref 00 E 55
External skirt	- Silk Grey	nearest BS ref 10 A 05
Columns, external corners	- Slate Grey	BS 4800 18 B 25
Columns, intermediate	- Grey	BS 4800 00 A 05
Windows	- Blue Grey	BS 4800 18 B 29
Doors:		
Insulated door	- Slate grey	nearest BS ref 18 B 25

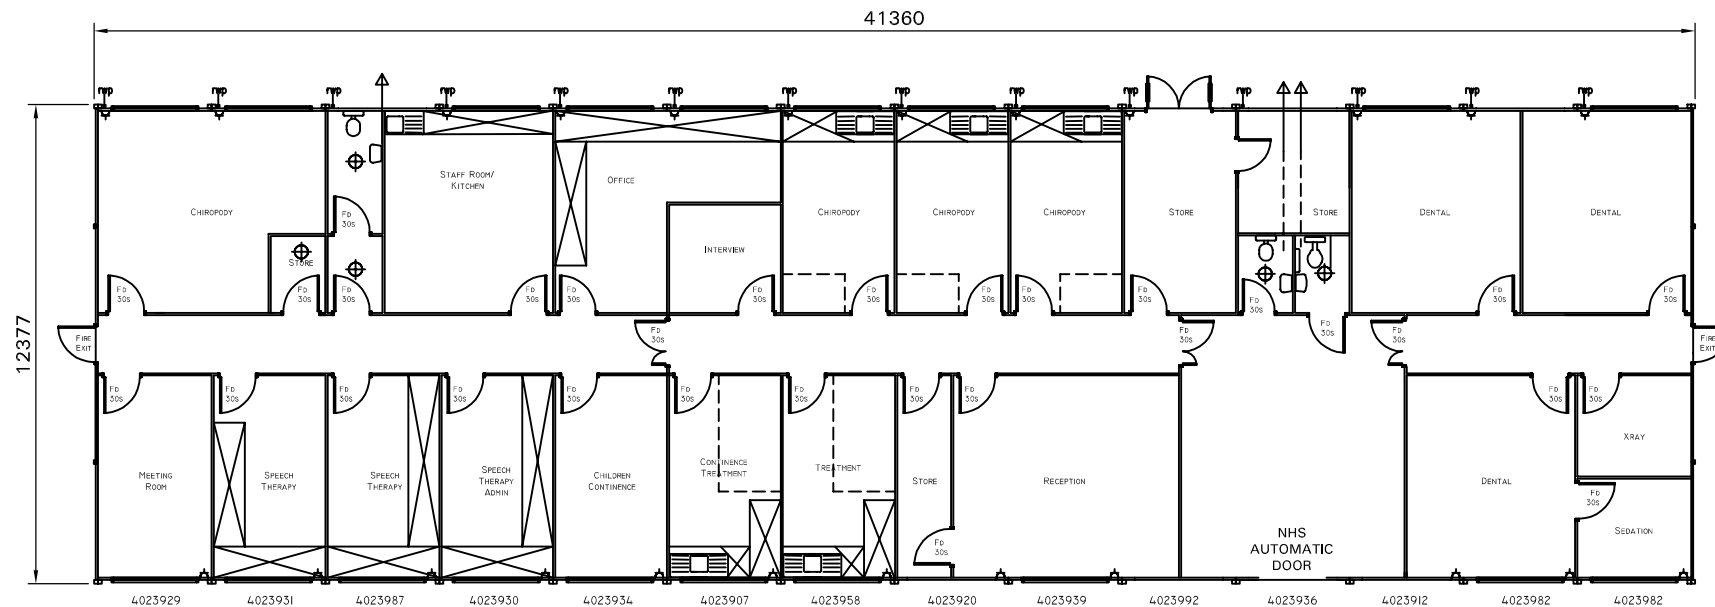

Total Floor Area = 496.30 Sqm

Duplex
 Building System

Portakabin Limited Huntington York YO32 9PT
 Telephone 01904 611655 Fax 01904 611644

Project		AS INSTALLED Accommodation	
Client		Cedar House Investments	
Title		DX402 x 14 Modules	
Date	Drawn	Viki Webster	
Scale		1:100 @ A1	
Drg. No.	Rev.		